WALL TYPE LEGEND

- EXIST'G WALLS TO BE REMOVED
- EXIST'G WALLS TO REMAIN
- NEW WALLS – INTERIOR COOLER WALLS – 3 1/2" THICK SANDWICH PANELS w/ FRP PANELS + SCIS
- NEW WALLS – INTERIOR WALLS – 5/8" GYP. BD. + SIDE OF 3x4's + 16" O.C. (1 SIDE AT EXT. WALL)
- NEW WALLS – INTERIOR WALLS – 5/8" GYP. BD. + SIDE OF 3x4's + 16" O.C.
- NEW BEARING WALLS – INTERIOR WALLS – 5/8" GYP. BD. + SIDE OF 3x4's + 16" O.C. – PROVIDE STUDS UNDER FLOOR/ROOF JOISTS ABOVE
- NEW WALLS – EXTERIOR WALLS – RB TYPICAL WALL SECTIONS
- NEW WALLS – FOUNDATION WALLS – RB TYPICAL WALL SECTIONS
- NEW WALLS – FIRE RATED WALL – RB-UL WALL RATING SPEC
- NEW WALLS – INTERIOR WALLS – 5/8" GYP. BD. + SIDE OF 3 1/2" MTL. STUDS + 16" O.C.

FLOOR PLAN NOTES

NOTE: NOT ALL NOTES MAY APPLY

1. FACE BRICK – COMMON BOND (TYP.)
2. 2x6 WOOD FRAMING (TYP.) RB WALL SECTIONS
3. ALUMINUM FRAME WINDOW/DOOR – RB WINDOW/DOOR SCHEDULES
4. NEW CONCRETE SIDEWALK RB SITE PLAN
5. PAINTED CORNER PER CONSUMERS PROVIDE ADA COUNTER 2'-6" MIN.
6. REMOVABLE COUNTER FOR CHECKOUTS
7. BULLET PROOF GLASS ENCLOSURE RB 7
8. MERCHANDISE SHELVING SEE OWNER
9. SEMI-GLASS MERCHANDISE DOORS + SHELVING (TYP.)
10. SEMI-GLASS COOLER PAN COIL UNIT RB 10
11. ADA APPROVED TOILET ROOM RB ENLARGED PLANS
12. CASHIER COUNTER
13. 3 BOWL SINK + HAND SINK RB P1
14. WATER MAIN SHUT-OFF RB P1
15. FLOOR DRAIN RB P1
16. WALL MOUNTED MOP SINK RB P1
17. ROOF DRAIN + OVERFLOW PER P1; SEE + NOT
18. ROOF LADDER PERMIT SEE + JOBS

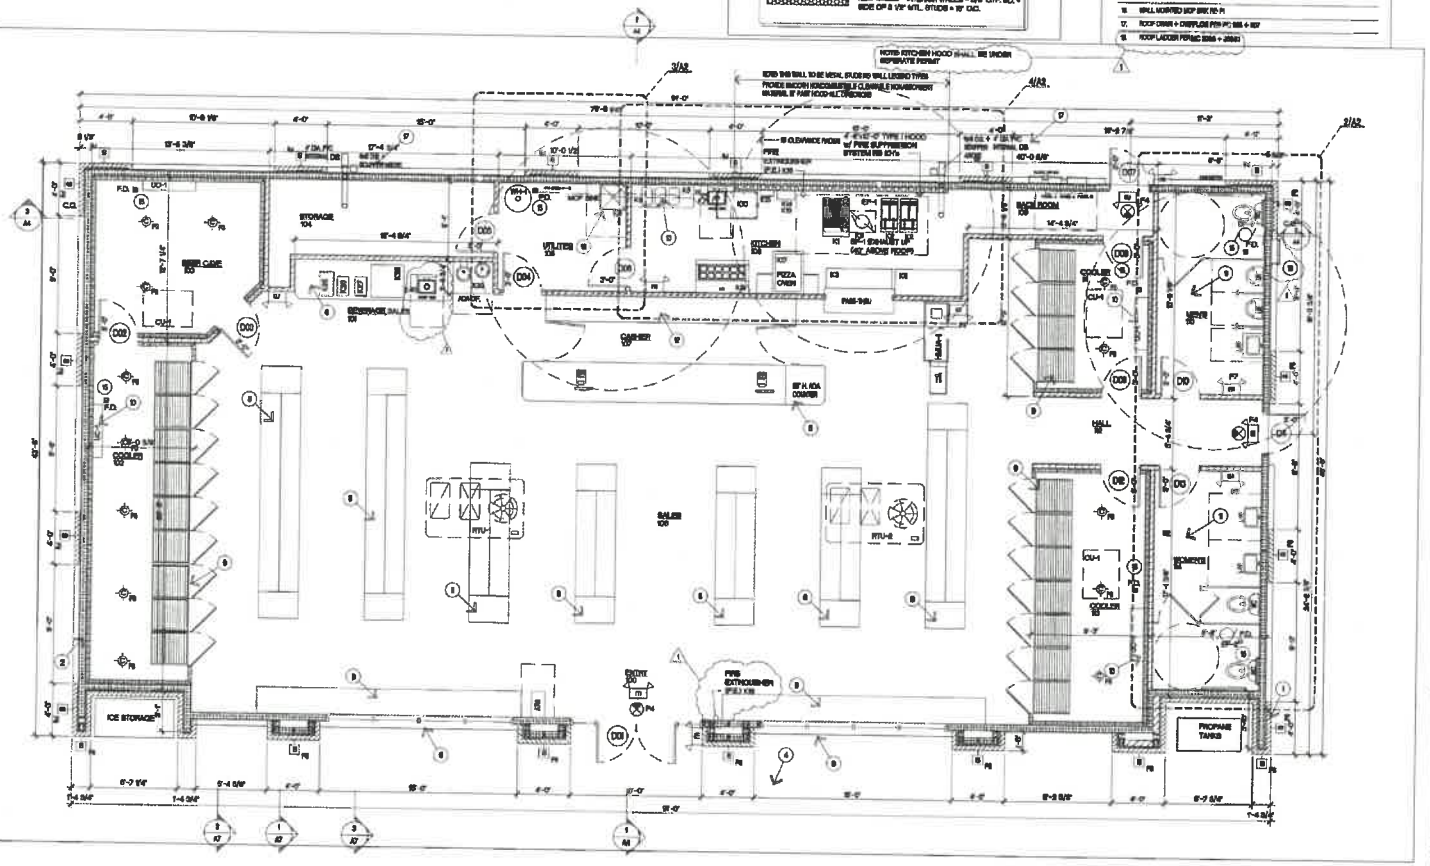

1 FIRST FLOOR PLAN

PROJECT N

STATE OF MISSOURI
SAMUEL DAVID BRAUN
REGISTERED ARCHITECT
9-26-19

DBL ARCHITECTURE + INC.

dblarchitecture.com
913-663-6626 – office
913-573-9008 – mobile
108 Kansas Ave | Bonner Springs 66012 USA

© COPYRIGHT – 2018
DBL ARCHITECTURE + INC.

The Design Concepts and Ideas Drawings are the Property of the Architect and are not to be copied without the Permission of DBL ARCHITECTURE + INC. Any use or partial use of these drawings without the permission of DBL ARCHITECTURE + INC. shall constitute a breach of contract. Any claims arising from such use shall not be enforceable.

Any revision or partial creation of these drawings without the permission of DBL ARCHITECTURE + INC. shall constitute a breach of contract. Any claims arising from such revisions shall not be enforceable.

Construction from these drawings shall only commence upon receipt of a full permit as issued by the appropriate government body. Any construction without the total permit shall constitute a breach of contract. Any claims arising from such construction shall not be enforceable.

PROJECT:

PERMIT NUMBER – 2018-00000
NEW CONVENIENCE STORE + SERVICE STATION
4500 Lee's Summit Road
INDEPENDENCE, MISSOURI 64055

PROJECT LOG:

CONTRACT INITIATION	11/12/18
AS-BUILT MEASURING/COMPLETION	7/7/18
OWNER'S DESIGN REVIEW	1/7/18
PLANNING PRE-APP REVIEW	10/22/18
PLANNING SPECIAL USE SUBMITTAL	1/7/18
OWNER'S CD REVIEW	7/7/18
PLANS AVAILABLE FOR PERMIT SUBMIT	2/20/19
PLANS PERMIT RESUBMIT	9/25/19

REVISIONS:

1. REVISED PER CITY 6/25/19, 9/25/19
2. REVISED PER CITY 7/7/19

SHEET TITLE:

FIRST FLOOR PLAN

SHEET NO.:

A1

PROJECT NUMBER:

111218